

Recording requested by:
BOARD OF SUPERVISORS
When recorded send to:
BOARD OF SUPERVISORS

**BEFORE THE BOARD OF SUPERVISORS OF THE
COUNTY OF AMADOR, STATE OF CALIFORNIA**

IN THE MATTER OF:

RESOLUTION APPROVING VARIANCE TO) RESOLUTION NO. 10-164
COUNTY CODE §19.24.040 "PD-R1" REQUIRING A)
15' REAR BUILDING SETBACK FOR TERRY)
MORRIS TO ALLOW CONSTRUCTION OF AN AS)
BUILT GARAGE ON APN 003-572-004-000.)

BE IT RESOLVED by the Board of Supervisors of the County of Amador, State of California, that said Board does hereby approve a request for variance from County Code §19.24.040, which requires a 15' rear setback to allow for construction of an "as-built" garage to within 6' of the front property line. (See Attachment "A").

The foregoing resolution was duly passed and adopted by the Board of Supervisors of the County of Amador at a regular meeting thereof, held on the 9th day of November, 2010, by the following vote:


AYES: Supervisors Brian Oneto, John Plasse, Theodore F. Novelli,
Richard M. Forster and Louis D. Boitano
NOES: None
ABSENT: None



CHAIRMAN, Board of Supervisors

ATTEST:

JENNIFER BURNS, Clerk of the
Board of Supervisors of Amador County,
California

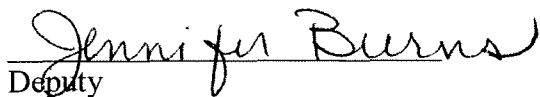




Deputy

FRONT STREET


LOT 13 140014WT CI.
ZONE, CA. 95640

TERRY MORRIS

APN# 003-572-004

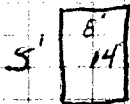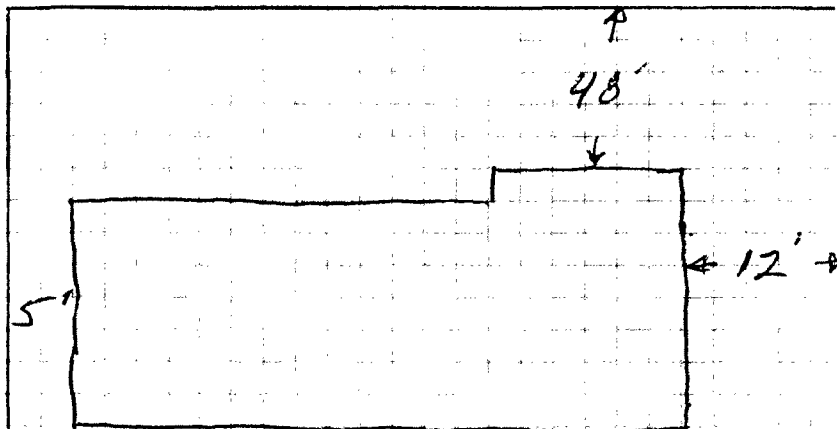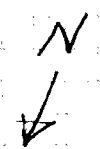


265'

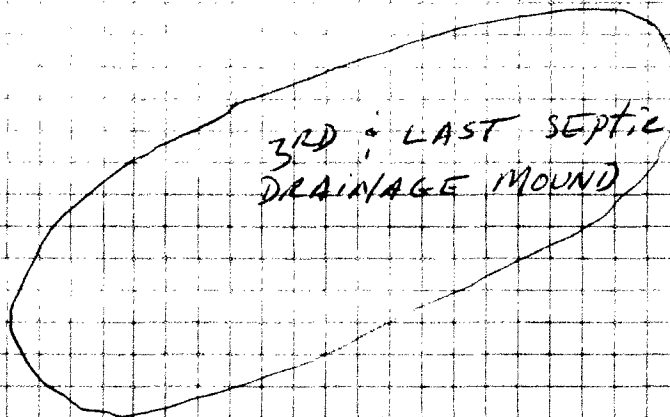

3RD & LAST SEPTIC
DRAINAGE MOUND

50'

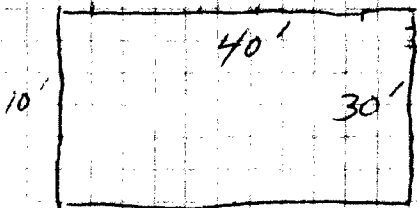

REAR PROPERTY

85'

ATTACHMENT
"A"